
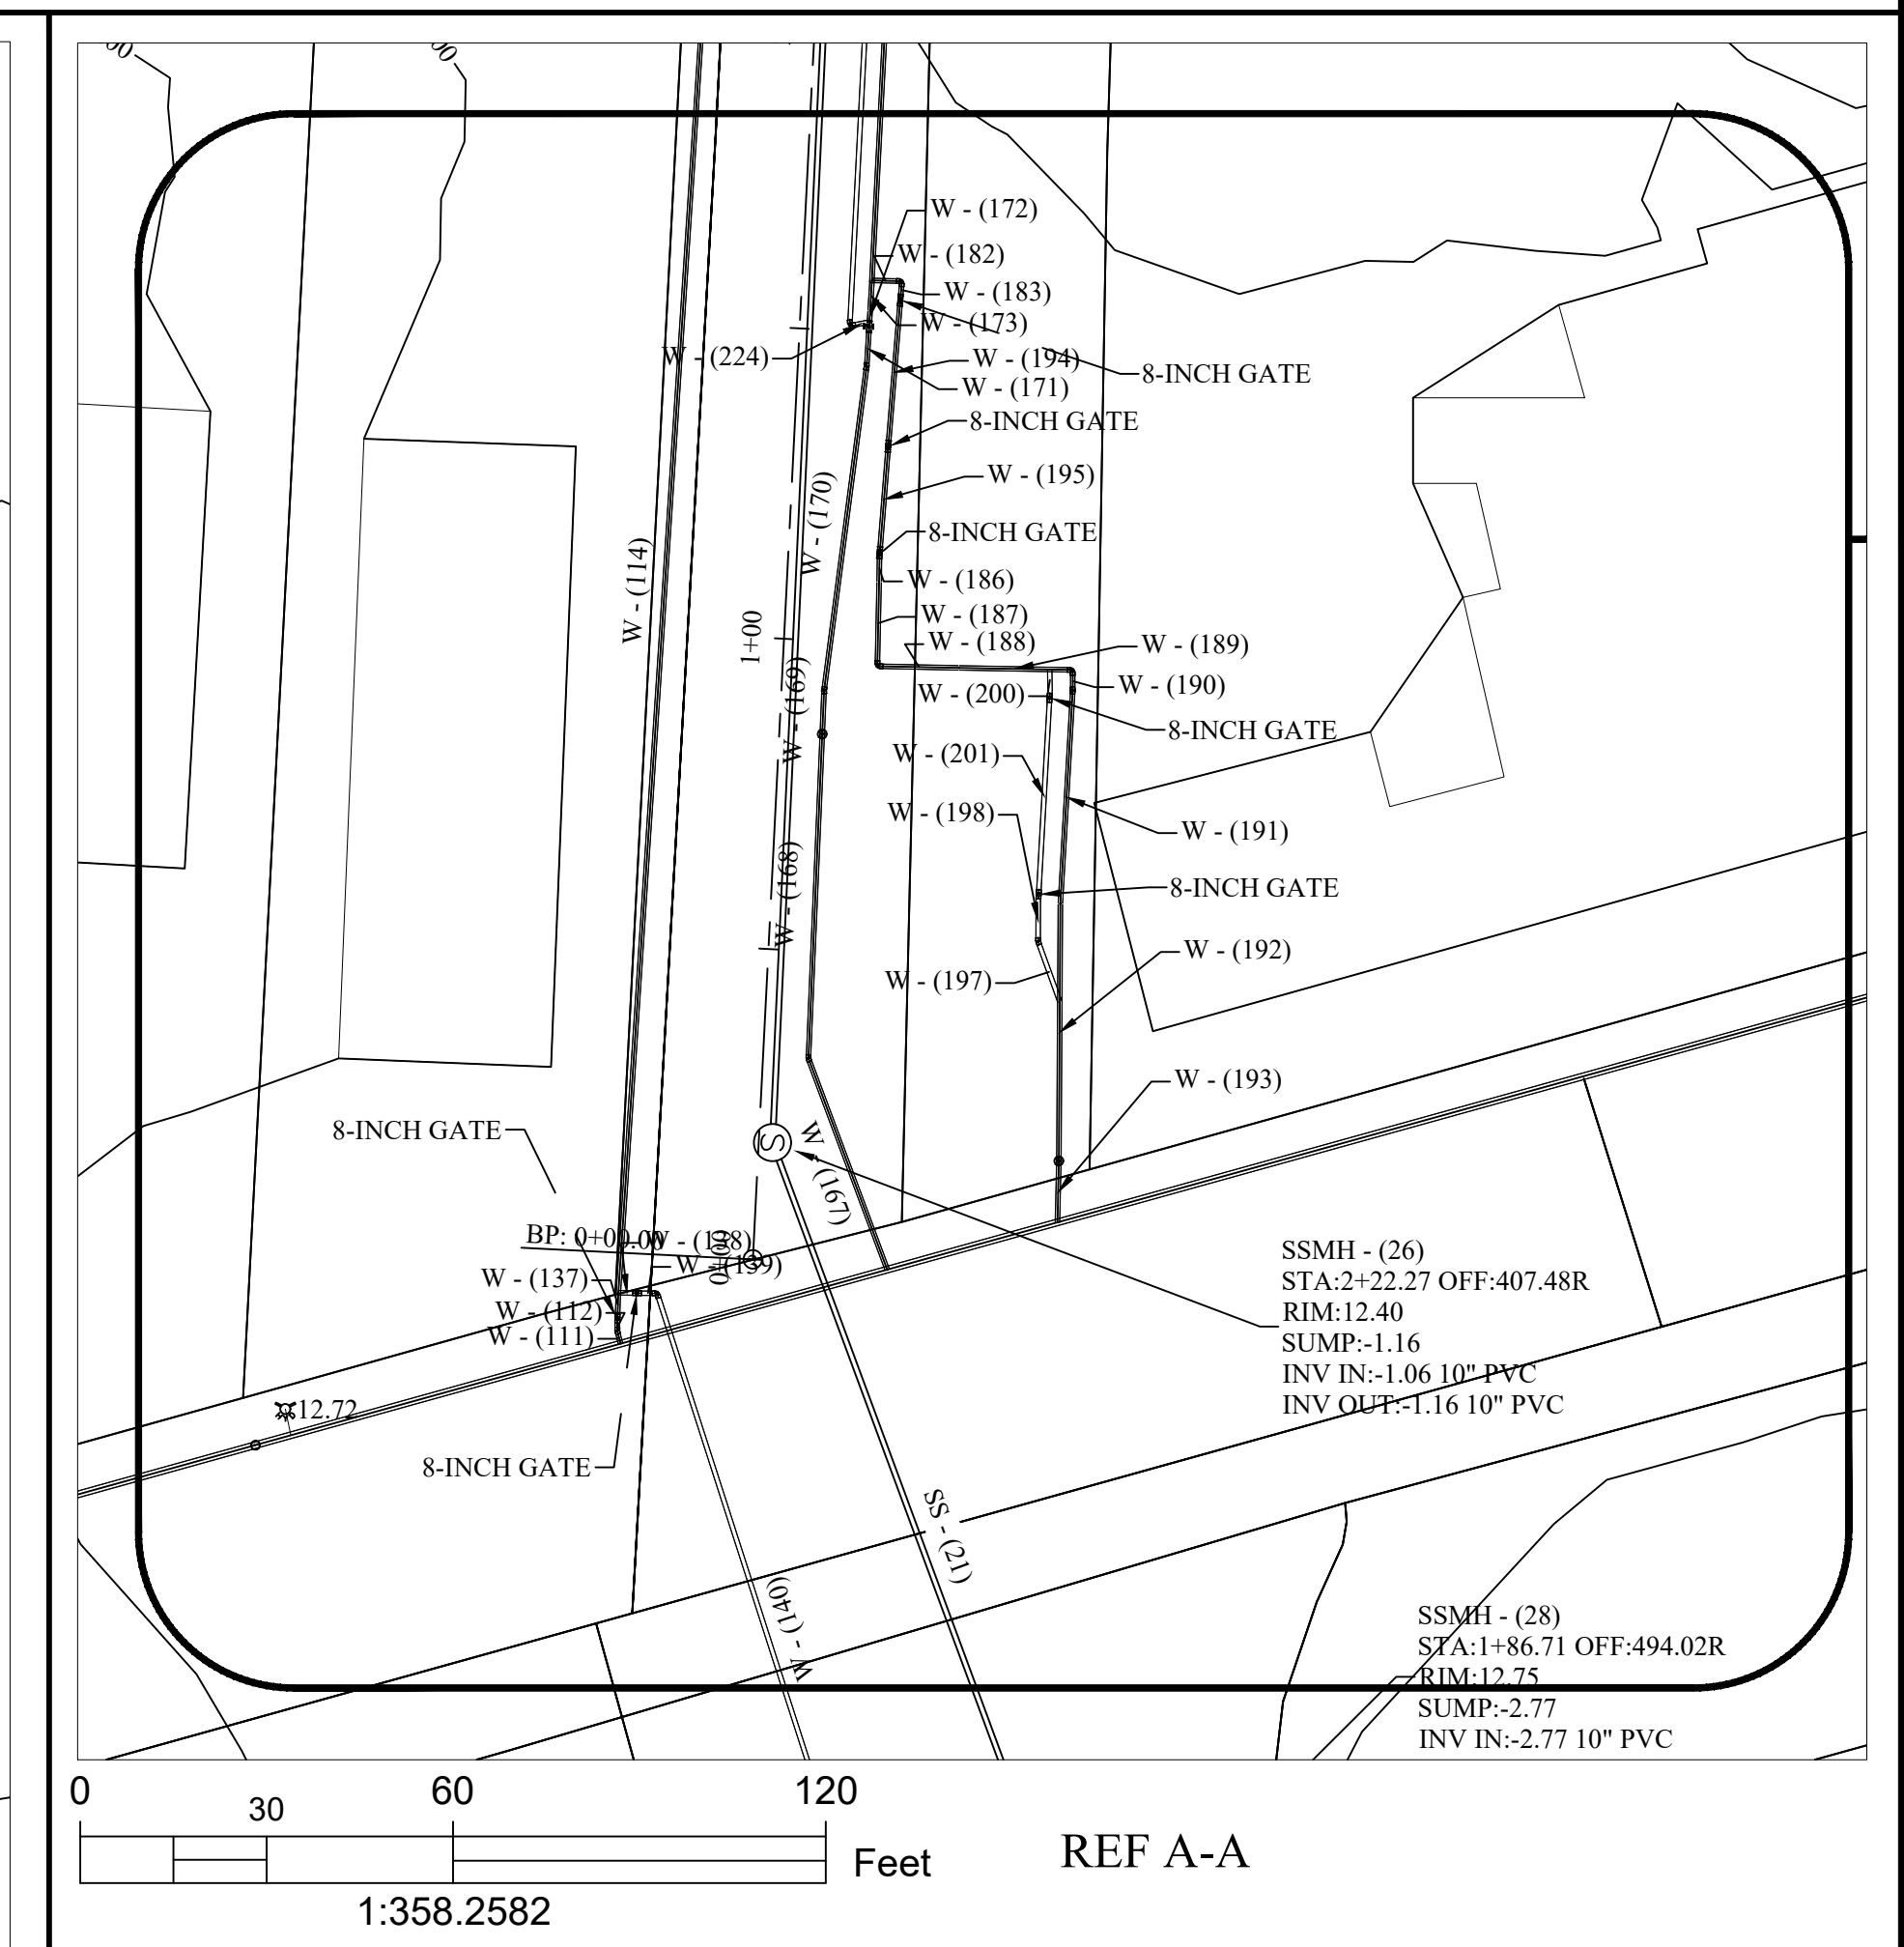


REVISIONS		
DATE	DESCRIPTION	BY

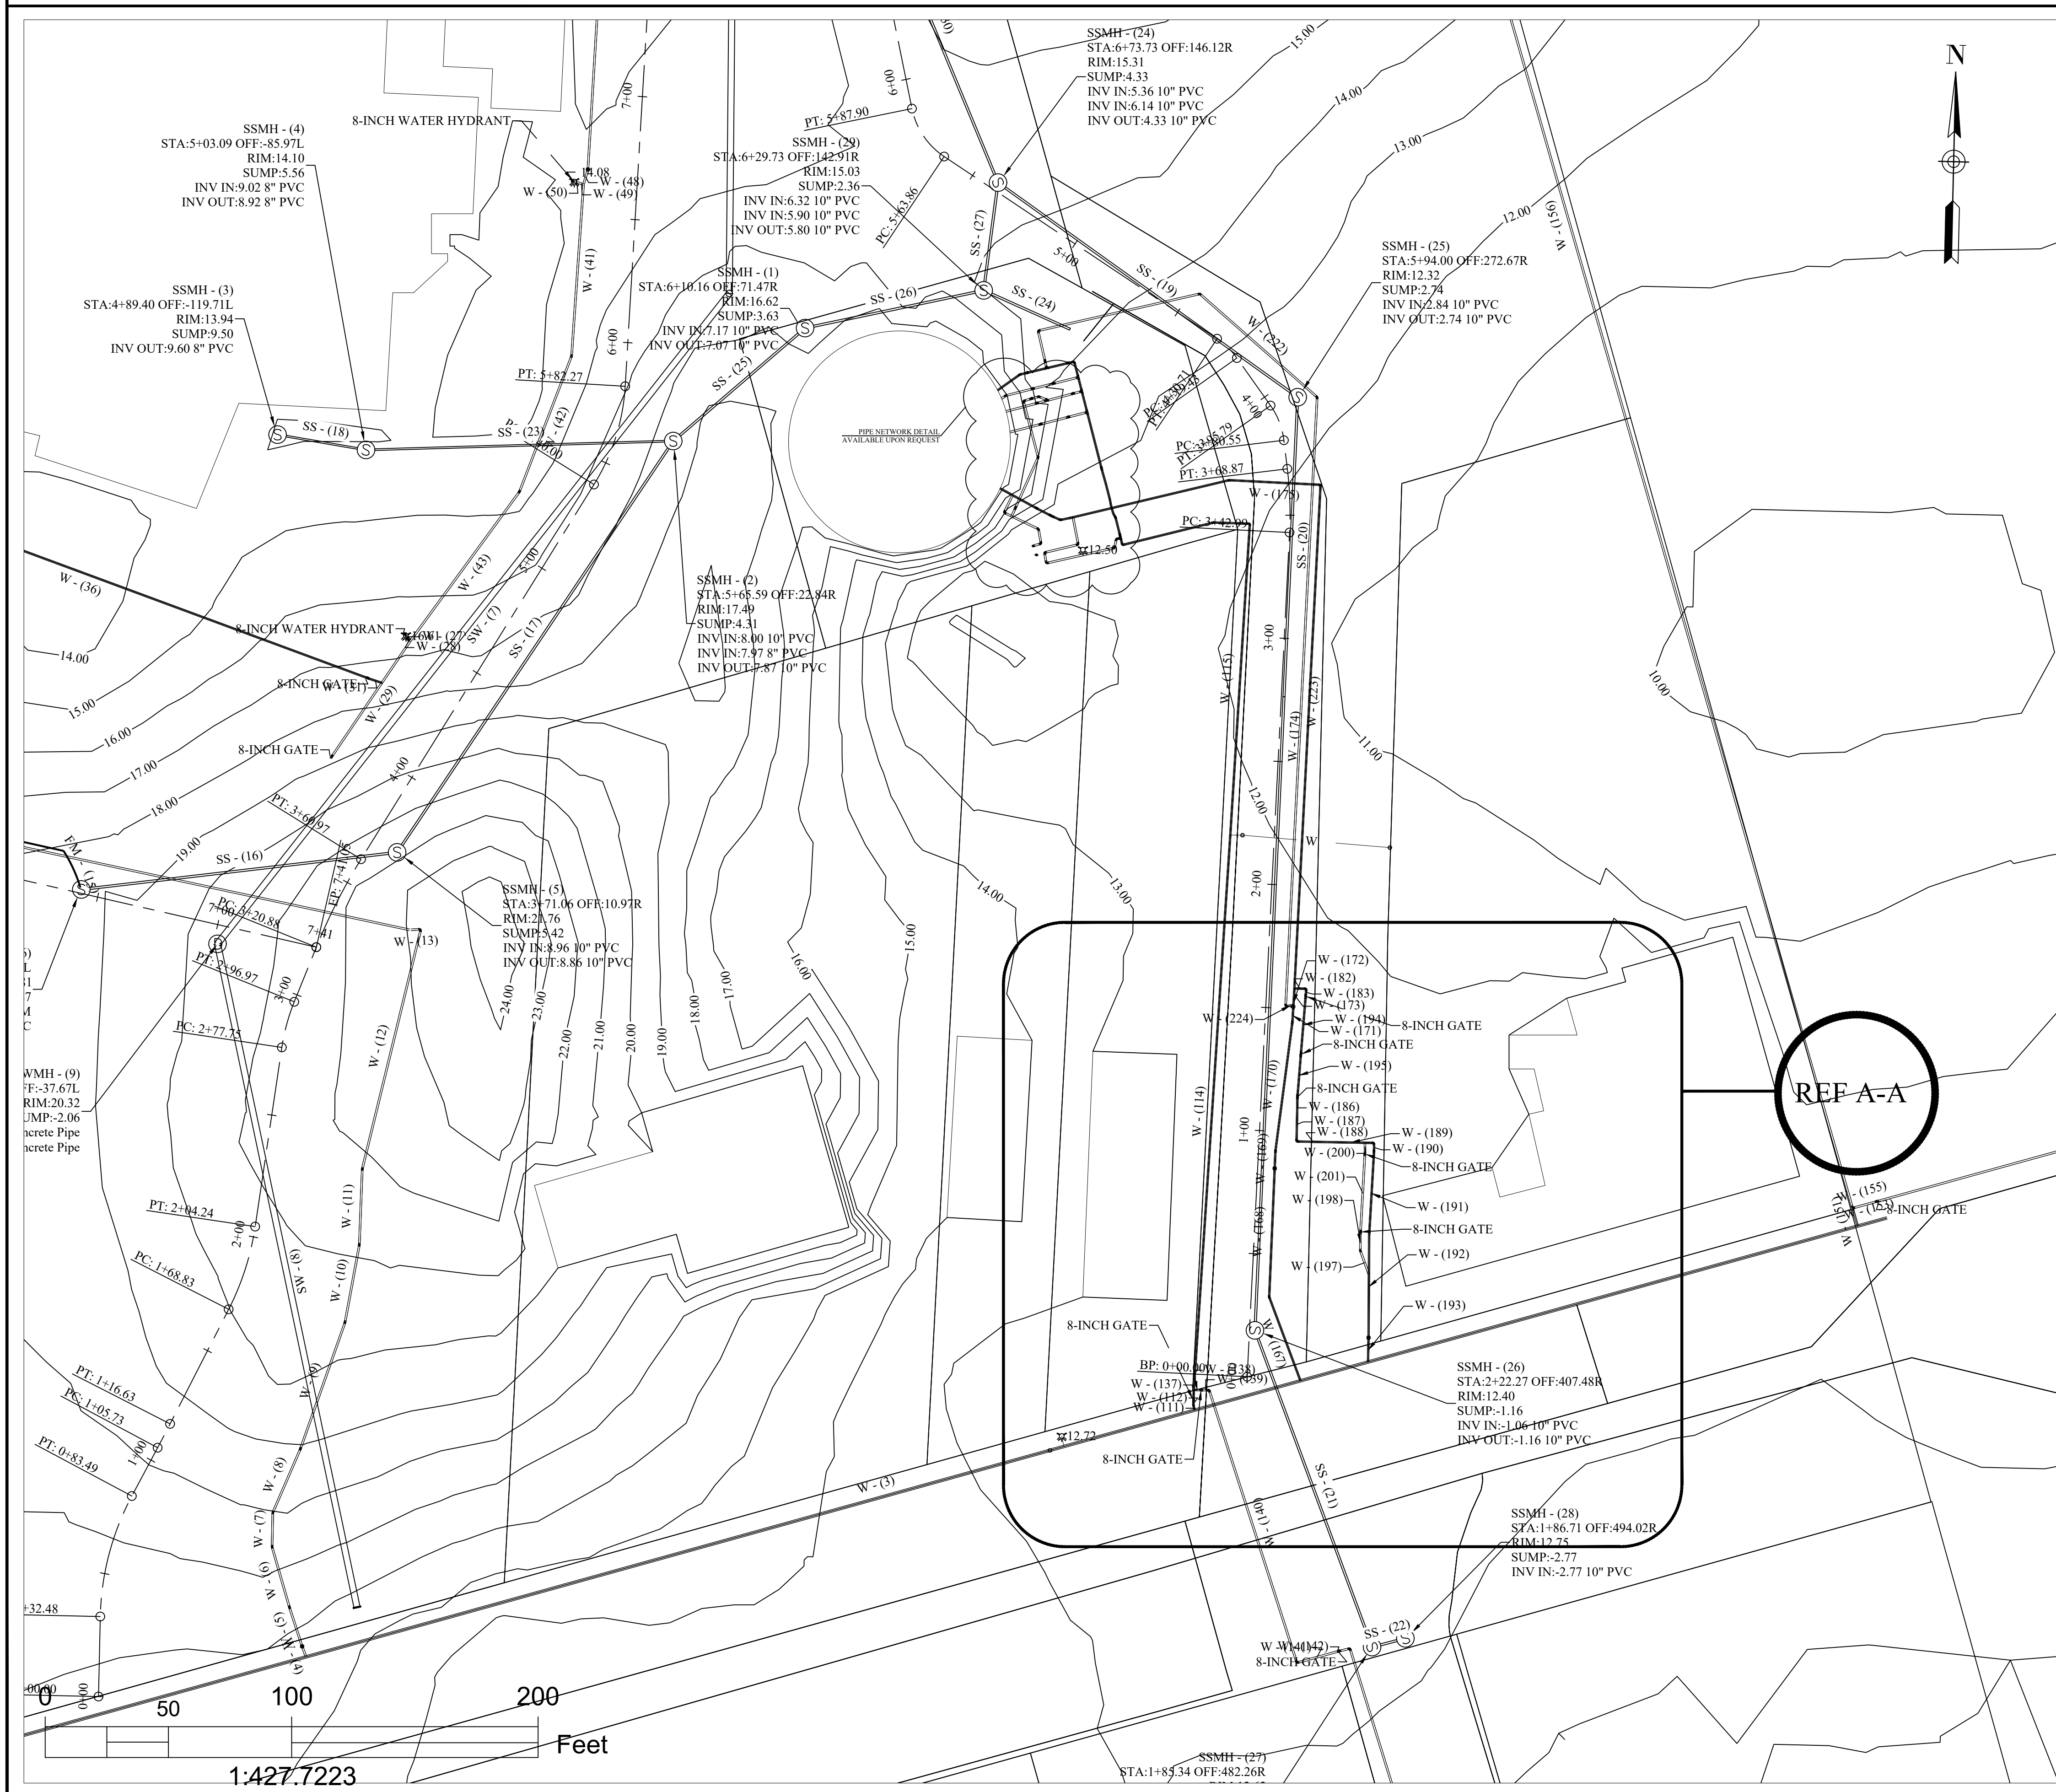

**AS-BUILT**  
Date: 4/29/2023

Drawing Location: Y:\Development\Projects\Procurement\PT-23-23\23.02.02 West Water Plant Upgrades\Drawings\Water\WaterPlant\bulb.dwg

WMH - (9)  
FS:-37.67L  
RIM:20.32  
JMP:-2.06  
herete Pipe  
herete Pipe

0	50	100	200
Feet			
1:427.7223			

		City of Gulf Breeze City Hall 1070 Shoreline Dr. Gulf Breeze, FL 32561 (850) 934-5100		PROJECT: <b>Baptist Hospital Water Loop Connection</b>
TITLE: <b>Site Overview no aerials</b>		CONSTRUCTION DATE: For As-Built	PHASE: For As-Built	
DATE: 1/26/23 DRAWN BY: KNUNLEY CHECKED BY: TLAMBERT		SCALE: GRAPHICAL	PROJECT NO: SHEET: 5 of 7	DRAWING INDEX: C-005